



- NOTES:**
1. All sizes to be taken and checked on site by contractor prior to preparation of shop drawings or fabrication of parts.
 2. This drawing should not be scaled. Any discrepancies to be brought to the immediate attention of the Contract Administrator.
 3. All services to Local Authorities, Building Control Officer and Environmental Health requirements and to Service Engineer's details.
 4. All structure to Structural Engineer's details and Local Authority and Building Control Officer's requirements.
 5. All construction and materials to comply with current Building and Fire Regulations.
 6. The Contractor shall comply with the CDM 2007 Regulations.

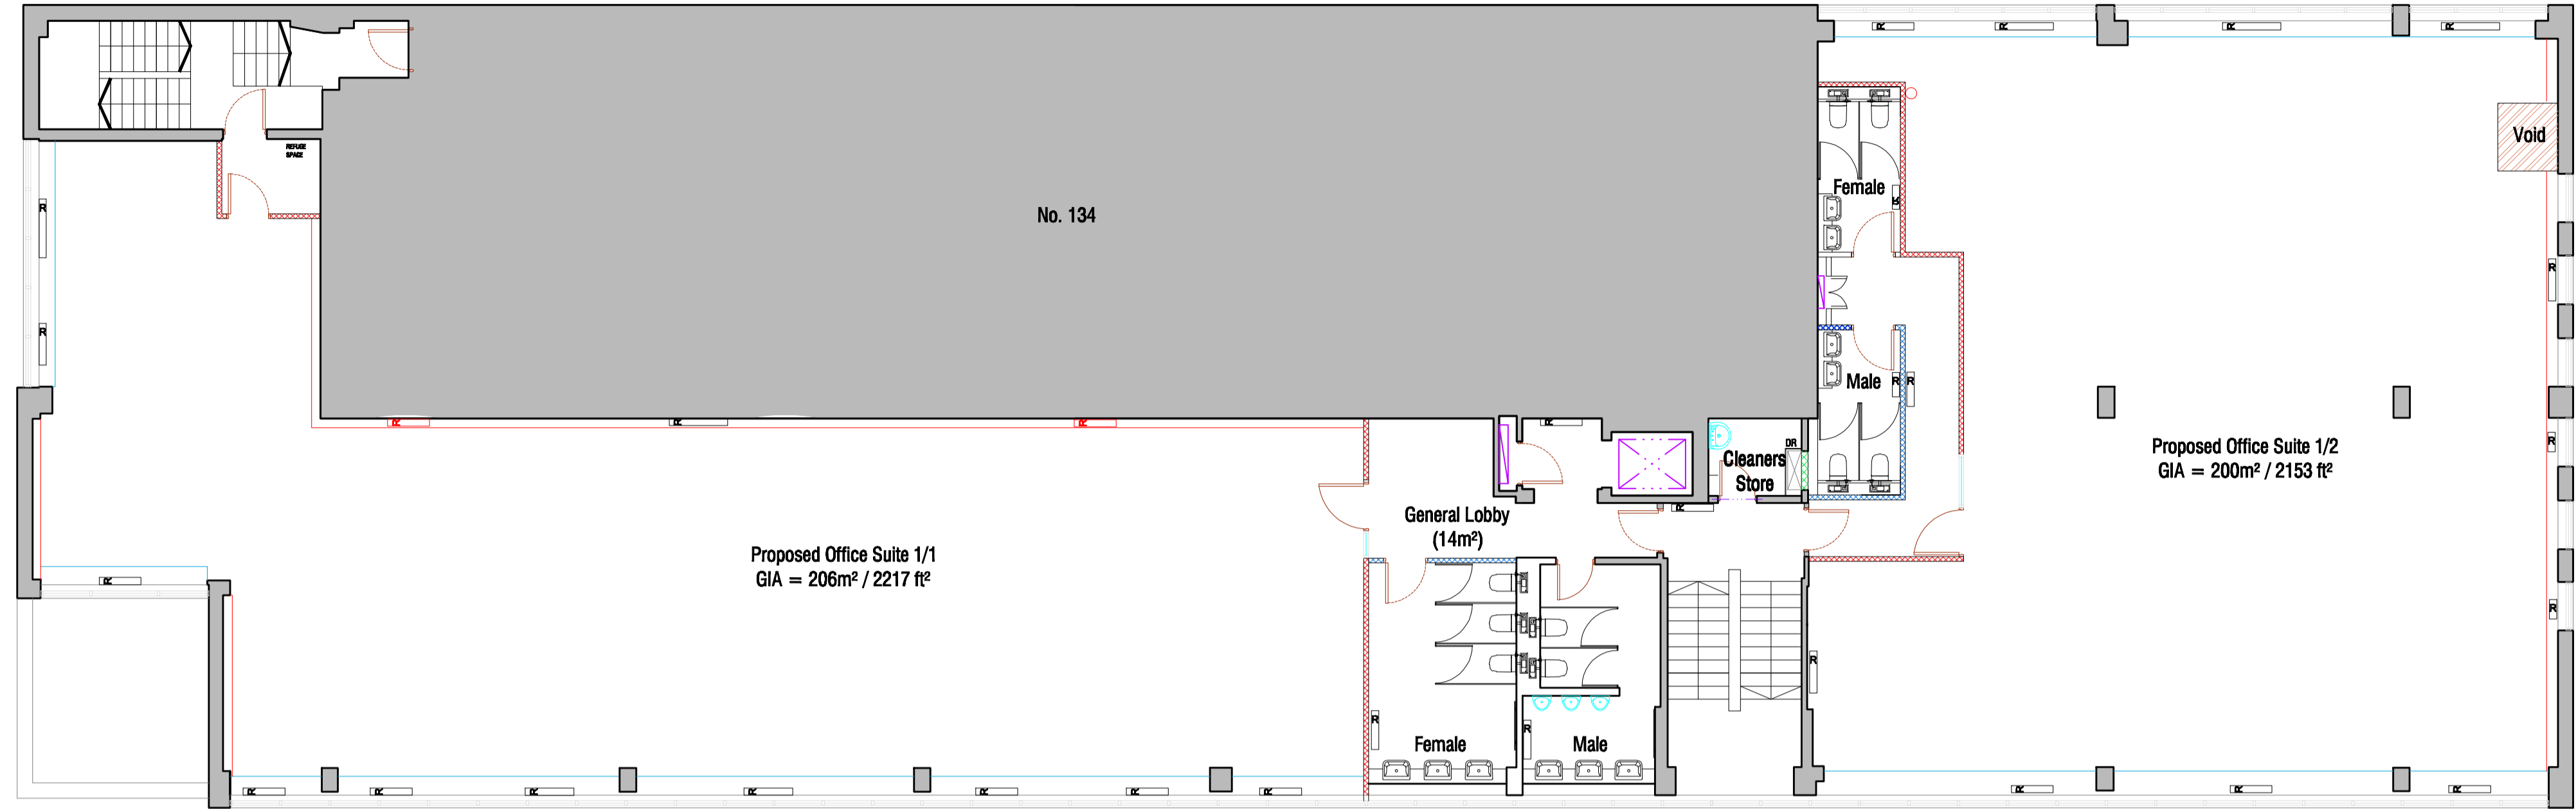


First Floor as Proposed

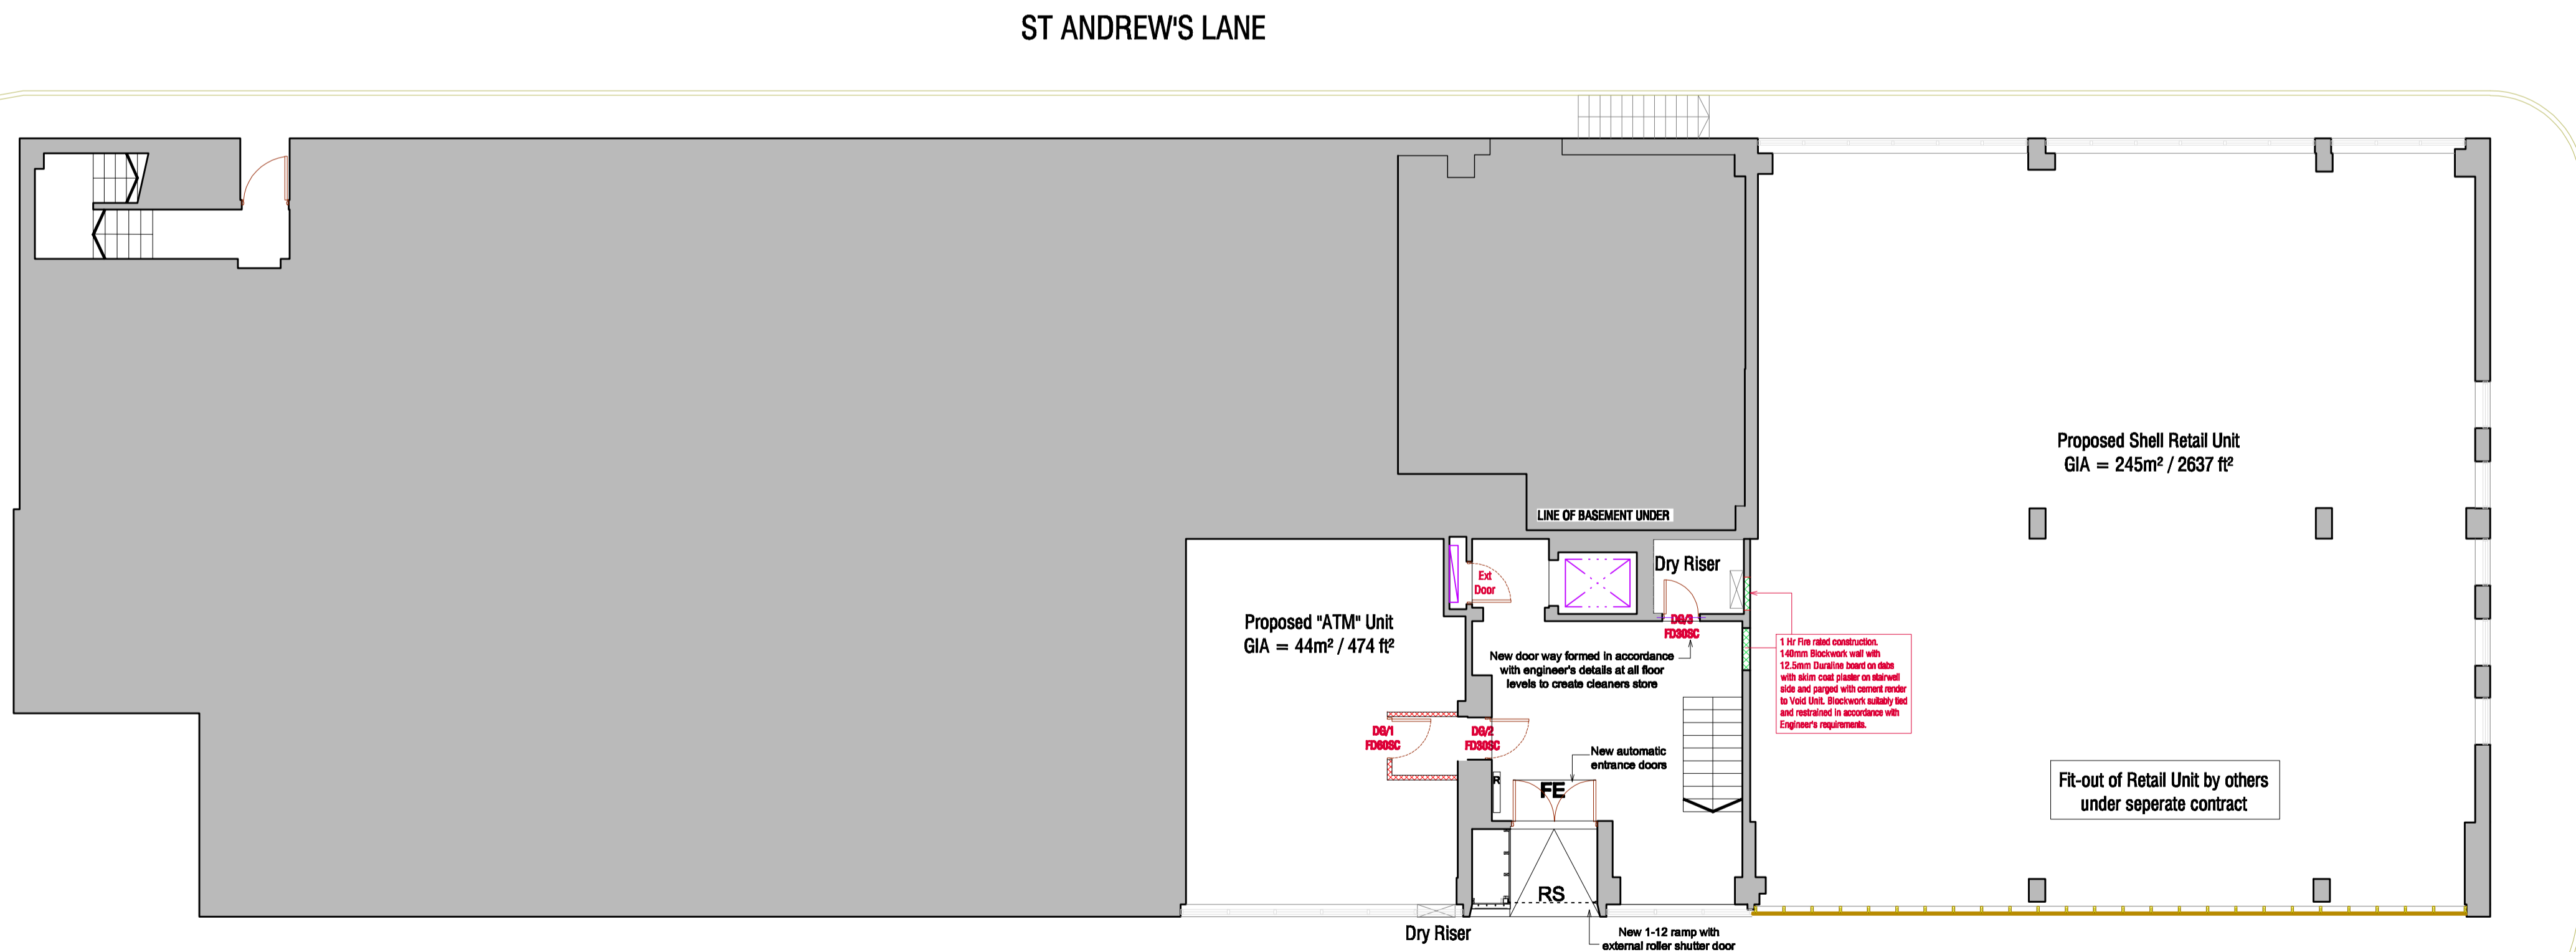

Ground Floor as Proposed

As Built

Revision:	Description	Date
Title: Ground / First Floor Layouts As Proposed		
Property: 132-134 Seagate Dundee		
Client: Seagate Enterprise LLP		
Scale: 1:100@A1	Date: 29/07/11	
Job no.: 1692(AB)	Dwg. no.: 04	
Issue: As Built	Drawn by: dgs	

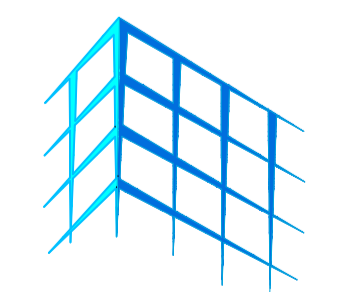

Mackinnon & Co
 chartered building surveyors architectural services project managers
 208 West George Street t. 0141 204 3311
 Glasgow f. 0141 204 3391
 G2 2PQ e. info@mackco.co.uk
www.mackinnon-building-surveyors.co.uk

SUGARHOUSE WYND