

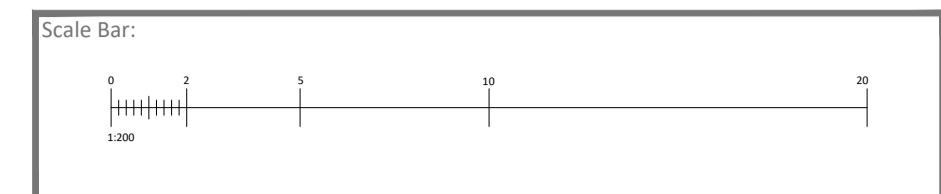


Copyright of this drawing remains the sole property of Domus Architecture unless otherwise assigned in writing. Do not scale from this drawing. Figured dimensions are to be worked in all cases with any discrepancies reported to Domus prior to commencement of any work. Only the original drawing should be relied on.

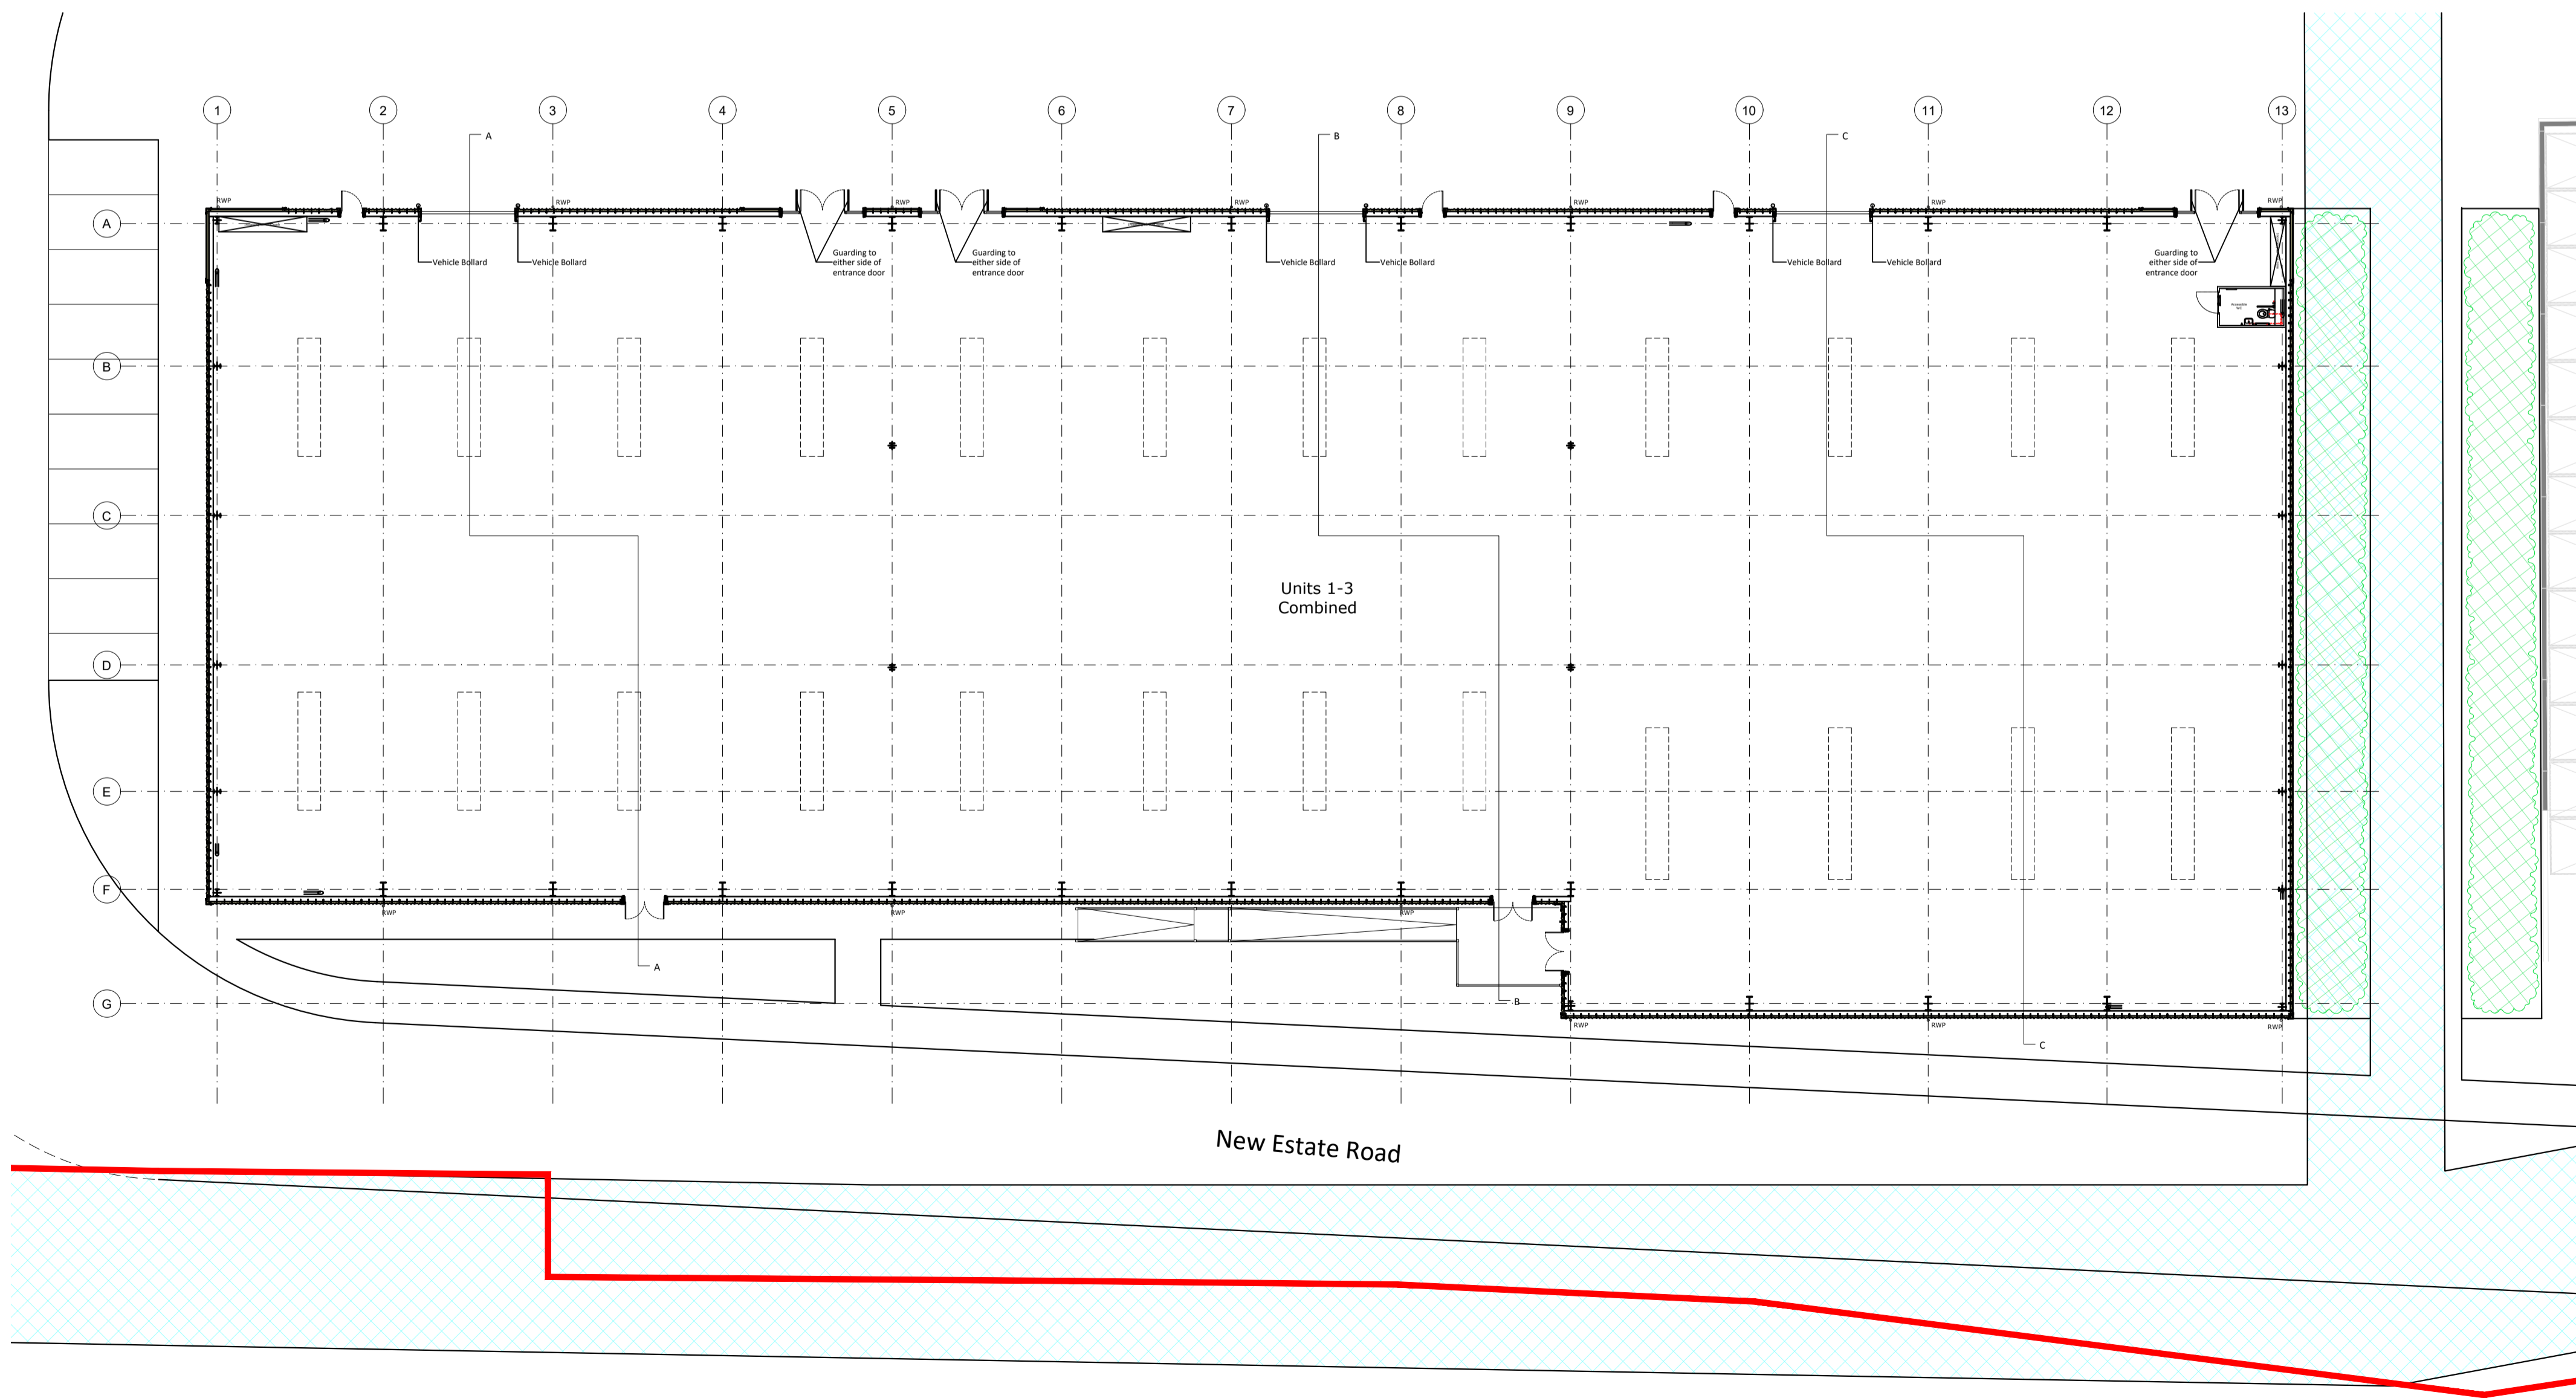

Revision	Date	Description	Checked
A	06/04/22	General update.	PS
B	28/04/22	Escape Doors to rear of Units B2-B4 and access ramped amended to suit comments from Building Control. Roof Plan added.	PS
C	03/05/22	Unit B4 enlarged to suit discussions with client.	PS
D	18/05/22	Sutcliffe's Steel information added onto drawing.	PS
E	25/05/22	Entrance doors shown as opening in the direction of escape to suit comments from Building Control. Unit B4 is in abeyance.	PS
F	27/05/22	Rainwater pipes updated to suit Excel's comments.	PS
G	10/06/22	Steel updated to suit Killeed's Steel design.	PS
H	14/10/22	General update to suit Excel's design.	PS
J	31/01/23	Separating walls omitted from scheme. Welfare amended to suit. Locations of installed services shown, as requested by construction team.	PS
K	04/04/23	Locations of all external guarding added.	JT
L	11/04/23	External guarding removed from fire escape doors to suit comments from Socotec.	JT
M	25/05/23	As-Built issue.	JT
N	08/09/23	As-Built issue.	JT

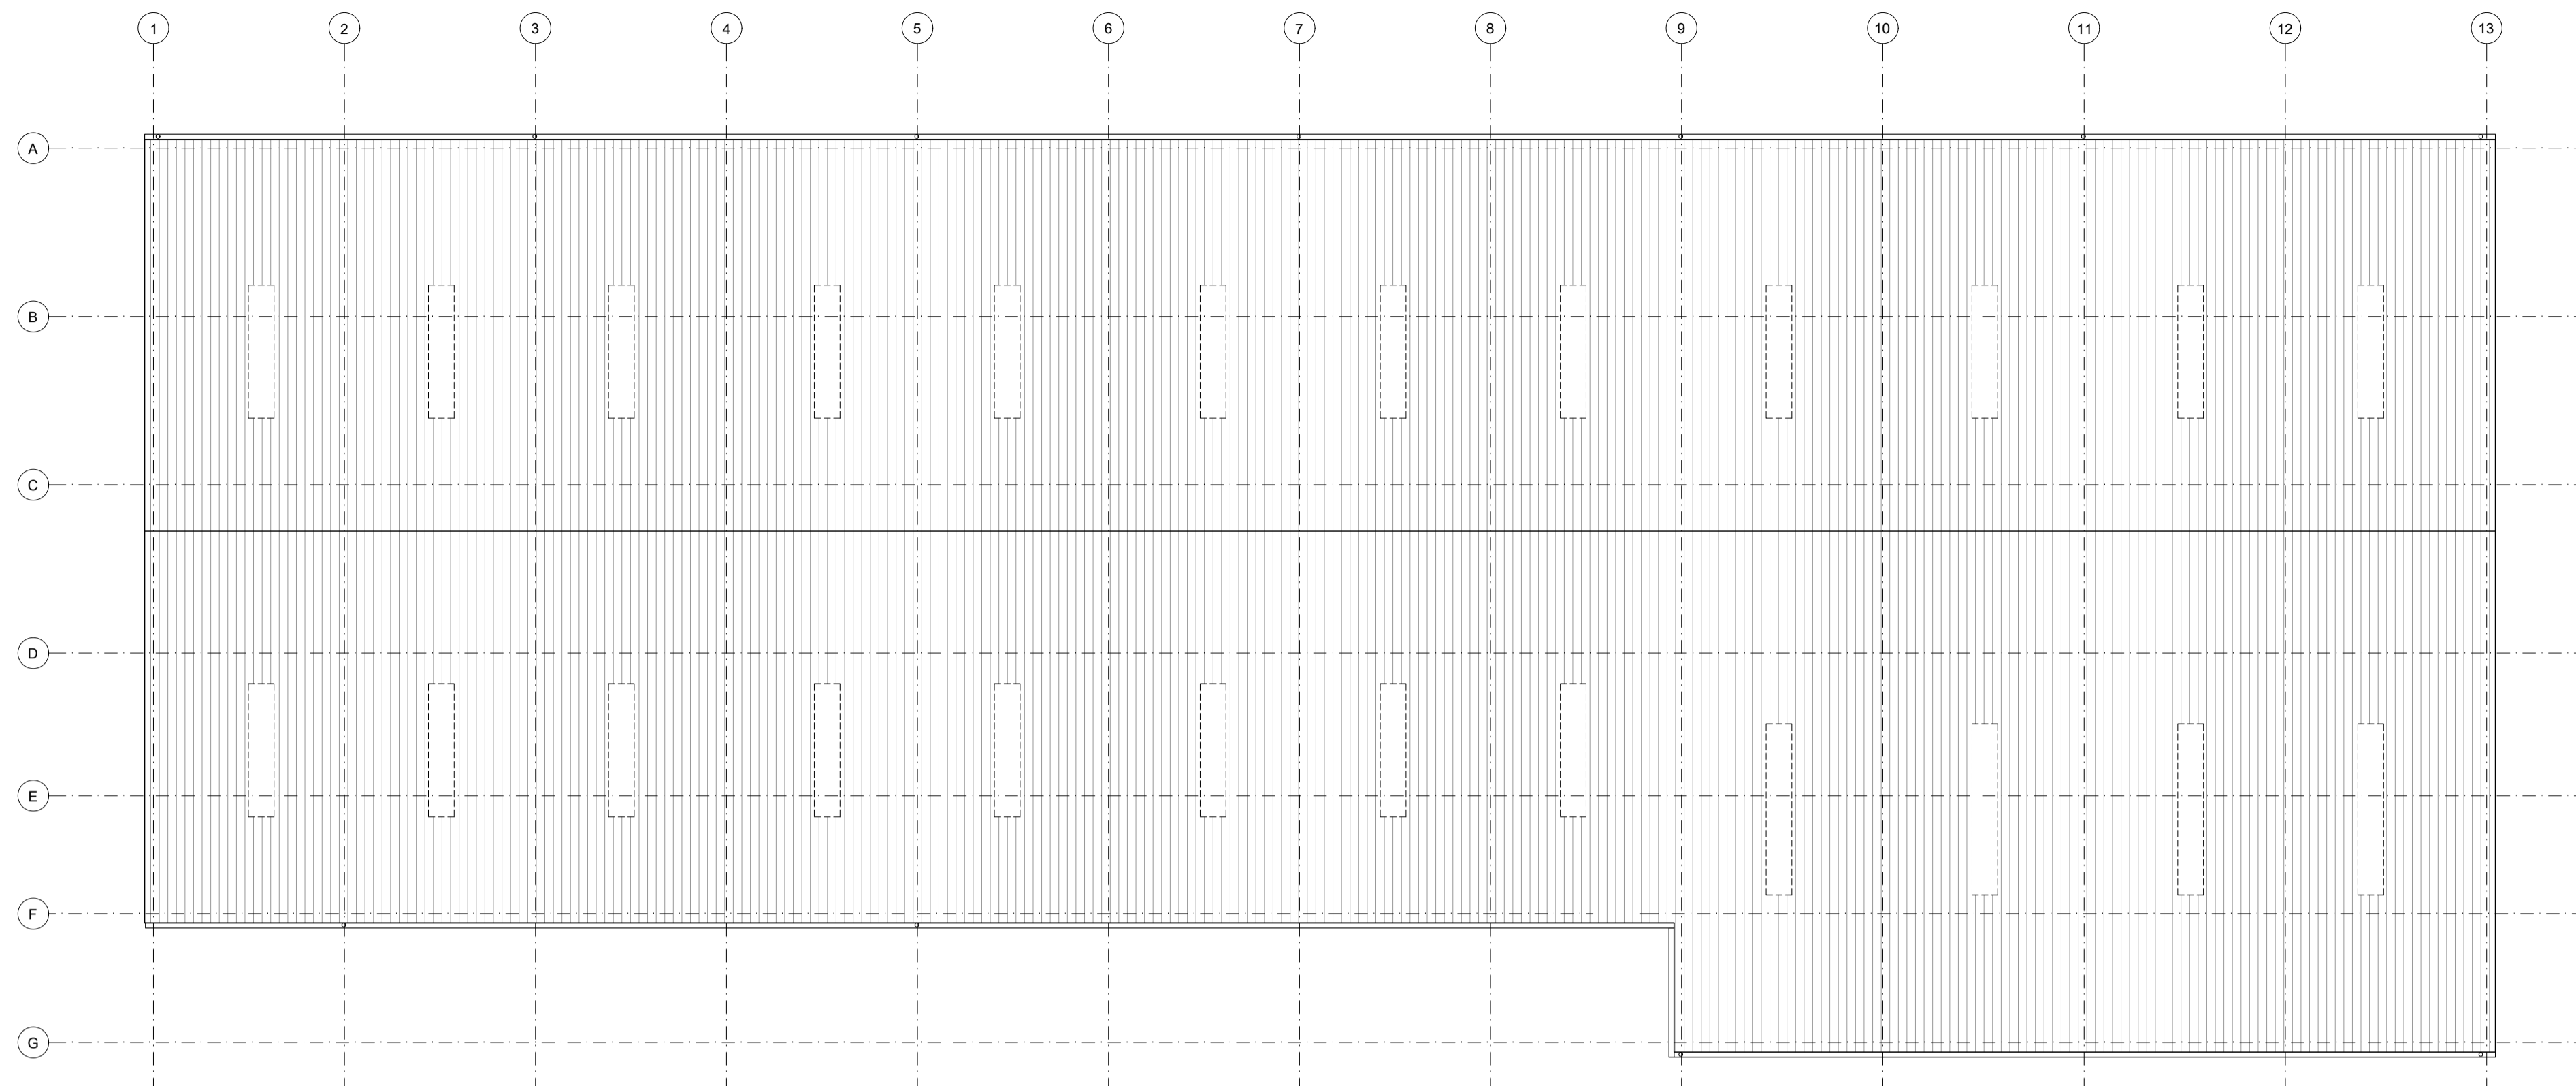

AS BUILT NOTE
 For reference, the information indicated within this AS BUILT drawing reflects the AS BUILT DESIGN only. It may not necessarily reflect the true construction and/or fabrication of the proposal indicated within this document.
 Should further, more in depth details be required, please refer back to the main contractors design lead portion of the contract, and or, sub-contractors fabrication drawings.

AS BUILT DRAWING



DOMUS
architecture

One Campbell Street
Leeds
LS28 6DP

T: 0113 518 1010
E: info@domusarchitecture.co.uk
W: domusarchitecture.co.uk

Project:	Industrial Development
Site Address:	Hay Hall Business Park
Client:	FI Construction Ltd
Title:	Block B GA Plans

Date: March 2022	Scale: 1:200 @ A1	Checked: PS
Project: 1900	Dwg No: A2-05	Revision: N