



HELLO@DTHREESTUDIO.CO.UK
DTHREESTUDIO.CO.UK
020 7096 9520

GENERAL KEY	
	DOOR REFERENCE NUMBER
	ROOM REFERENCE NUMBER
	PT 1 NEW 100mm FULL HEIGHT PARTITION
	PT 2 BOXING IN
	PT 2 EXISTING PARTITION
	PLY LINING
	NEW SOLID PAINT GRADE DOOR
	NEW GLAZED SHOP FRONT DOOR

NOTES

DTHREE STUDIO DO NOT ACCEPT LIABILITY FOR ANY ERRORS AND OMISSIONS ARISING FROM THE PREPARATION OF BASE BUILD DRAWINGS WHICH ARE DERIVED FROM ORIGINAL MATERIAL PROVIDED BY OTHERS.
ALL DISCREPANCIES ARE TO BE REPORTED TO DTHREE STUDIO.
GRID LINES ARE FOR REFERENCE PURPOSES ONLY. ALL DIMENSIONS TO BE VERIFIED BY CONTRACTOR ON SITE PRIOR TO ANY WORKS COMMENCING. DO NOT SCALE FROM THIS DRAWING.
THIS DOCUMENT IS THE PROPERTY OF DTHREE STUDIO.
COPYRIGHT IS RESERVED BY THEM, AND THE DRAWING IS ISSUED ON THE CONDITION THAT IT IS NOT COPIED, REPRODUCED OR RETAINED BY, NOR DISCLOSED TO ANY UNAUTHORISED PERSON, EITHER WHOLLY OR IN PART, WITHOUT THE CONSENT IN WRITING FROM DTHREE STUDIO.

© DTHREE STUDIO



STATUS

- Approval / Comment
- Building Control
- Contract
- Construction
- As-Built

REVISION DETAIL

REV	DETAIL	BY	DATE
SK04	GROUND FLOOR SPLIT UNIT OPTION	HM	29/01
SK05	GROUND FLOOR SPLIT ALTERNATE	HM	29/01
P1	FIRST TECHNICAL ISSUE	HM	04/02
C1	CONSTRUCTION ISSUE	HM	15/02
C2	REVISED WC DETAIL	HM	10/03

CLIENT

BPP

PROJECT ADDRESS

NW WORKS
BUILDING C UNIT 2
135 SALUSBURY ROAD
NW6 6RN

DRAWING TITLE

UNIT 2 - FIRST FLOOR
GENERAL ARRANGEMENT
WORKING DRAWING

DWG NO: 33363-01-GA


REVISION: C2

SCALE @A1: 1:50 @ A3: 1:100


DATE: 21.10.20

DRAWN BY: HM

CHECKED BY: -

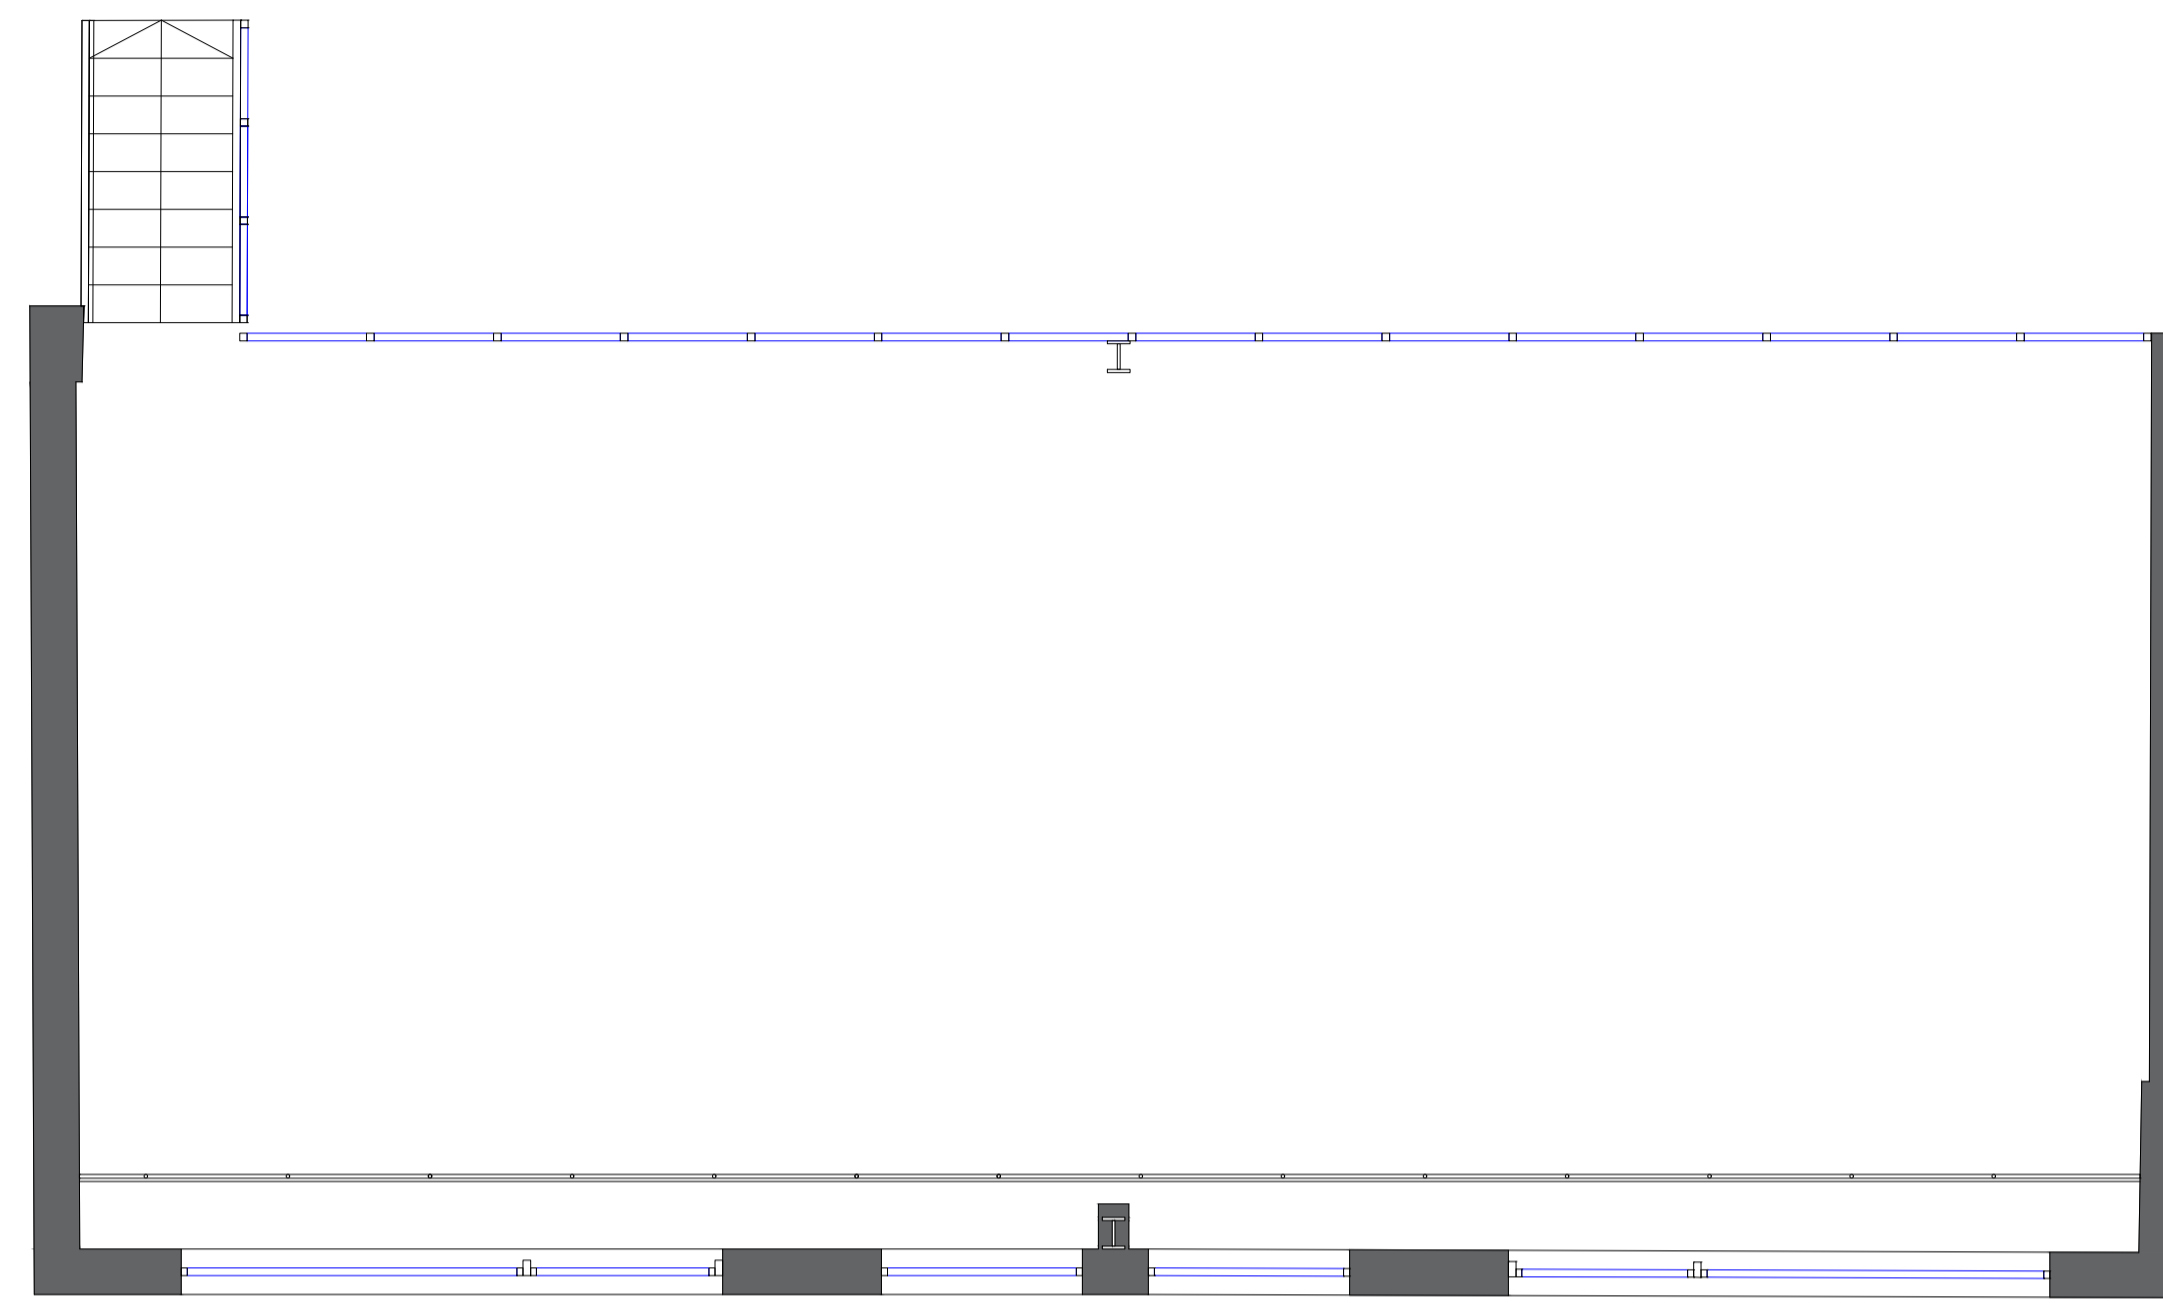

Mezzanine

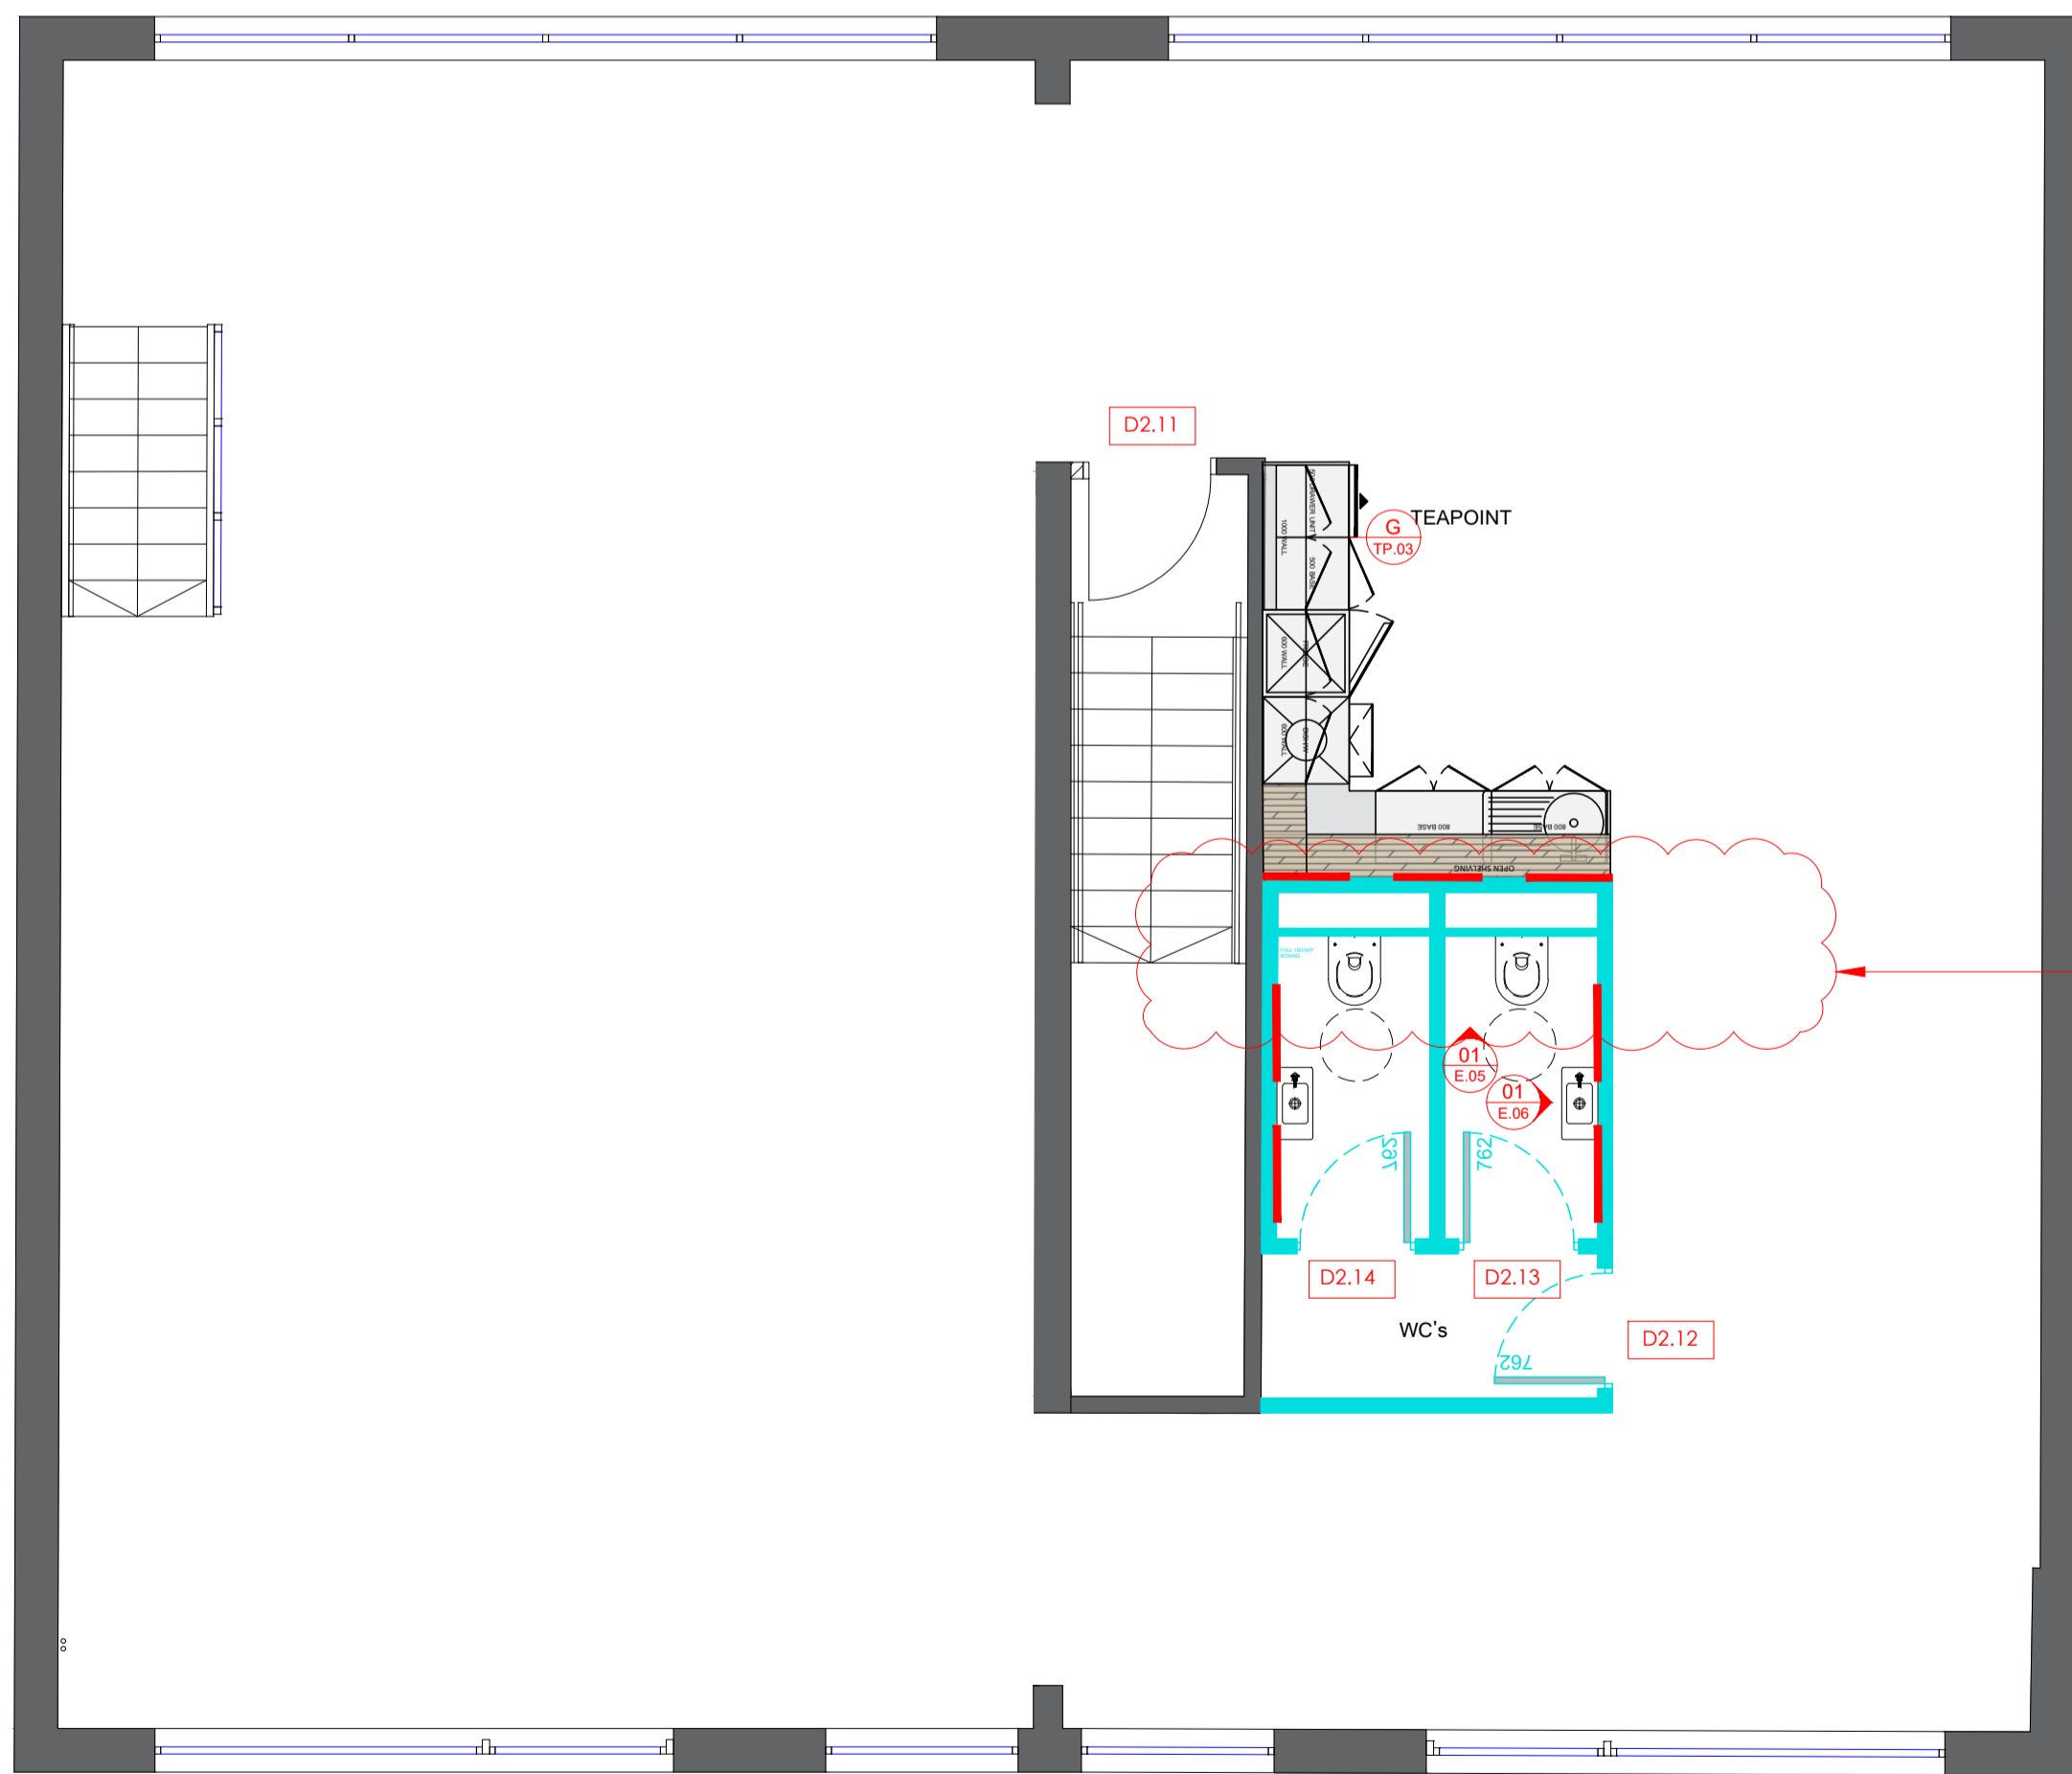

First Level

WC SERVICE VOID
TO BE FULL HEIGHT
TO SERVICE BOTH SVP
AND EXTRACT DUCT
THROUGH FLOOR

