


SEE DRAWING MA0746-123-602 FOR WC DETAILS

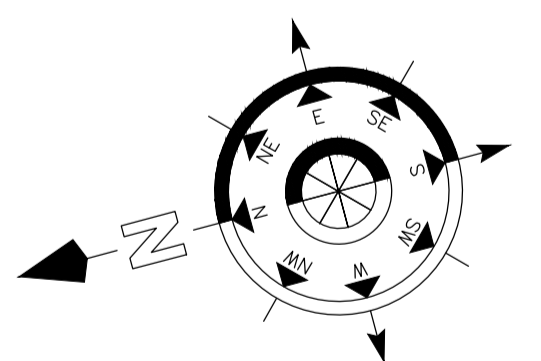

This drawing is protected under Copyright and at no time must any portion of this drawing be reproduced or copied in anyway without the permission of Morgan Lovell.  
All dimensions must be checked on site and NOT scaled from this drawing.

Rev	Revision	By	Date
F	RECORD DRAWING.	SB	10.01.13
E	DOOR REFERENCES ADDED.	SB	30.10.12
D	FUTURE TENANTS RISER OMITTED.	SB	25.09.12
C	CONSTRUCTION ISSUE.	SB	01.08.12
B	LIFT RISERS BACK WALLS SHOWN IN CORRECT LOCATIONS. WC LAYOUT REVISED. WC LOBBY DOORS REMOVED.	SB	21.05.12
A	RISER LOCATIONS INDICATED.	SB	03.05.12

**Morgan Lovell**  
Inspiring office transformation

Ascot House Finchampstead Road Wokingham Berks RG40 2NW  
T: 0118 989 5300 F: 0118 989 5301 E: contact@morganlovell.com  
W: http://www.morganlovell.com

Client  
**THREADNEEDLE PROPERTY INVESTMENTS**  
Project  
**28 CLARENDON ROAD  
WATFORD**

**RECORD DRAWING**

Title  
**SECOND FLOOR PLAN  
GENERAL LAYOUT**

Scale	Date	Designer/Drawn By	Checked By / Date
1:50@A1	21/02/12	SMKB/AN	

Drawing Number			
Project No.	Floor	Drawing No.	Rev
<b>MA0746</b>	<b>2</b>	<b>103</b>	<b>F</b>