


**SECOND FLOOR**  
GIA 257.2m<sup>2</sup>

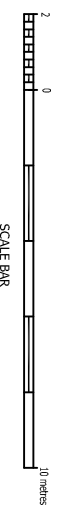

REV	DESCRIPTION	BY	CHK	APP	DATE

Client:

MJ Estates  
4th Floor - 4.02, 102 Petty France,  
London SW1H 9AJ

**terrain**

Land and Architectural Surveyors



**WYG** Urban & Landscape Design part of the WYG Group

Langston Court, 47 Newson Road, Cardiff CF24 0AD  
Tel: 0300 300 2000  
Email: planning Cardiff@wyg.com www.wyg.com

Project:  
Probation Estate Record Drawings  
Survey date:

Drawing Title:

19-37 High Street, Stockport,  
Cheshire SK1 1EG UPRN GMP50040  
Second Floor Plan

Scale	@ A3	Drawn	Date	Checked	Date	Approved	Date
1:200							
Project No.	A081648	Office Type	A	Drawing No.	GMP50040 - 04	Revision	

creative minds safe hands